


UNLADEN WEIGHTS

FRONT: 14,740LBS (6.69 TONNES)
 REAR: 19,480LBS (8.84 TONNES)
 TOTAL: 34,220LBS (15.53 TONNES)



LADEN WEIGHTS

FRONT: 15,526LBS (7.04 TONNES)
 REAR: 38,306LBS (17.38 TONNES)
 TOTAL: 53,832LBS (24.42 TONNES)

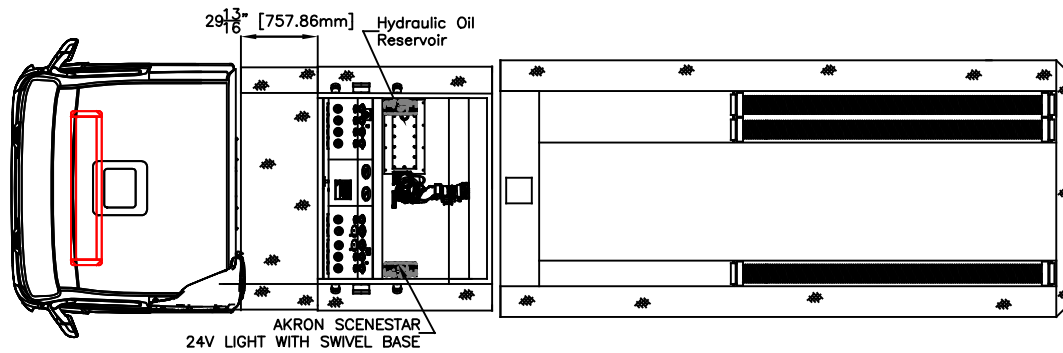

Left Side Compartmentation				
Compt	Doors	Opening Dimensions	Inside Dimensions	Volume
L1	Roll Up	47.5"Wx55"H	54.5"Wx59"Hx24.25"D	45.9 CU FT
L2	Roll Up	49"Wx23"H	56"Wx28"Hx24.25"D	22 CU FT
L3	Roll Up	49"Wx23"H	56"Wx28"Hx24.25"D	22 CU FT
L4	Roll Up	43"Wx55"H	50"Wx59"Hx24.25"D	42.1 CU FT
Right Side Compartmentation				
Compt	Doors	Opening Dimensions	Inside Dimensions	Volume
R1	Roll Up	47.5"Wx55"H	54.5"Wx59"Hx24.25"D	45.9 CU FT
R2	Roll Up	49"Wx23"H	56"Wx28"Hx24.25"D	22 CU FT
R3	Roll Up	49"Wx23"H	56"Wx28"Hx24.25"D	22 CU FT
R4	Roll Up	43"Wx55"H	50"Wx59"Hx24.25"D	42.1 CU FT
Total Volume				264 CU FT

7570.824 L (2000 Gal) Foam Tank
 Hale QMAX-XS225
 2250 GPM (7570 LPM) Pump
 Servo-Command Pump Module

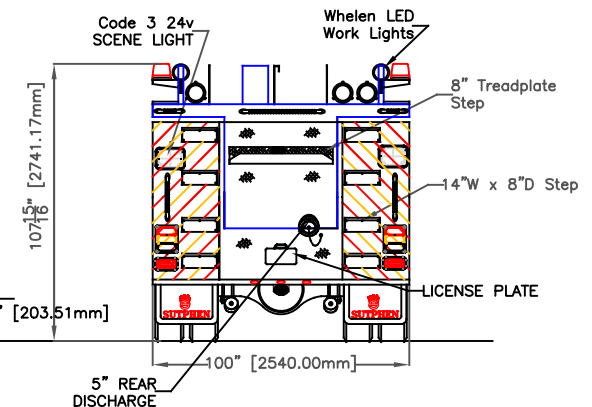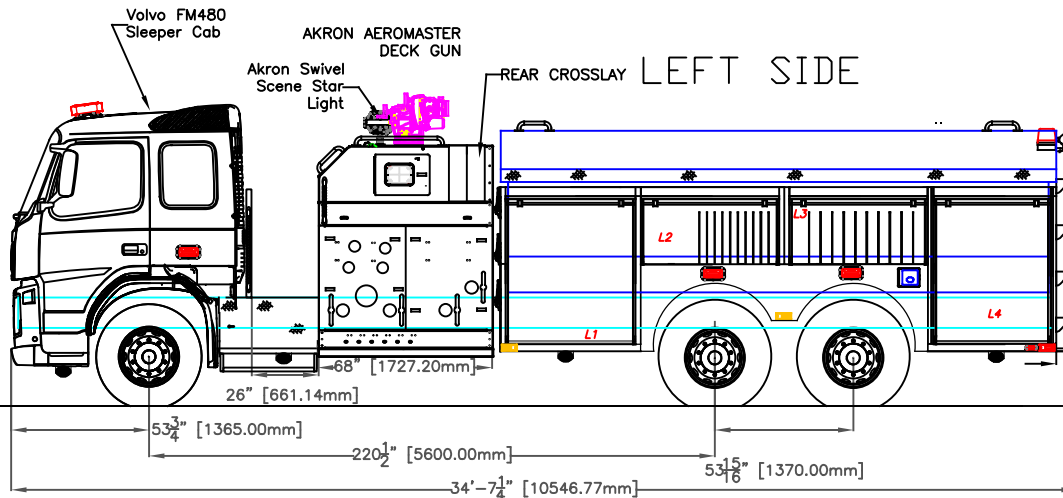

DIMENSIONS SHOWN ON THIS DRAWING ARE APPROXIMATE AND ARE SUBJECT TO MINOR DEVIATIONS DURING CONSTRUCTION.

IN THE EVENT OF A DISCREPANCY BETWEEN THE SUTPHEN SPECIFICATIONS AND DRAWING, THE SUTPHEN SPECIFICATIONS SHALL PREVAIL.

DRAWING IS FOR REFERENCE ONLY. SOME ITEMS PROPOSED MAY NOT BE SHOWN OR NOTED.

CUSTOMER APPROVAL	
NAME:	
TITLE:	
DATE:	

REV.	DESCRIPTION	BY	DATE
E	AS BUILT FINAL DRAWING	SED	10/22/19
A	HANDRAIL LOCATION AND CHANGE ORDER A	SED	6/13/19
REV.	DESCRIPTION	BY	DATE

DRAWN BY:	S.Dorfman
DATE:	8/21/18
MFG. FACILITY:	SUTPHEN EAST LAKE ARIEL

SUTPHEN
 PTT GLOBAL CHEMICAL
 BUSCON BROTHER'S INTERNATIONAL CO.
 Commercial Industrial Pumper-Tanker
 DWG. NO.: HS 6483

THIS PRINT IS PROVIDED ON A RESTRICTED BASIS AND IS NOT TO BE USED IN ANY WAY DETRIMENTAL TO THE INTEREST OF SUTPHEN CORPORATION.